LEGEND	
	Fall prevention anchorage
	Ladder access bracket
	Permanent ladder rung
	Permanent access ladder
	Horizontal/vertical static line
	Walkway
SGN	Signage
	Roof access hatch
	Permanent ladder platform

AFPA - Access Fall Prevention Anchor

DFPA - Diversion Fall Prevention Anchor

MFPA - Main Fall Prevention Anchor

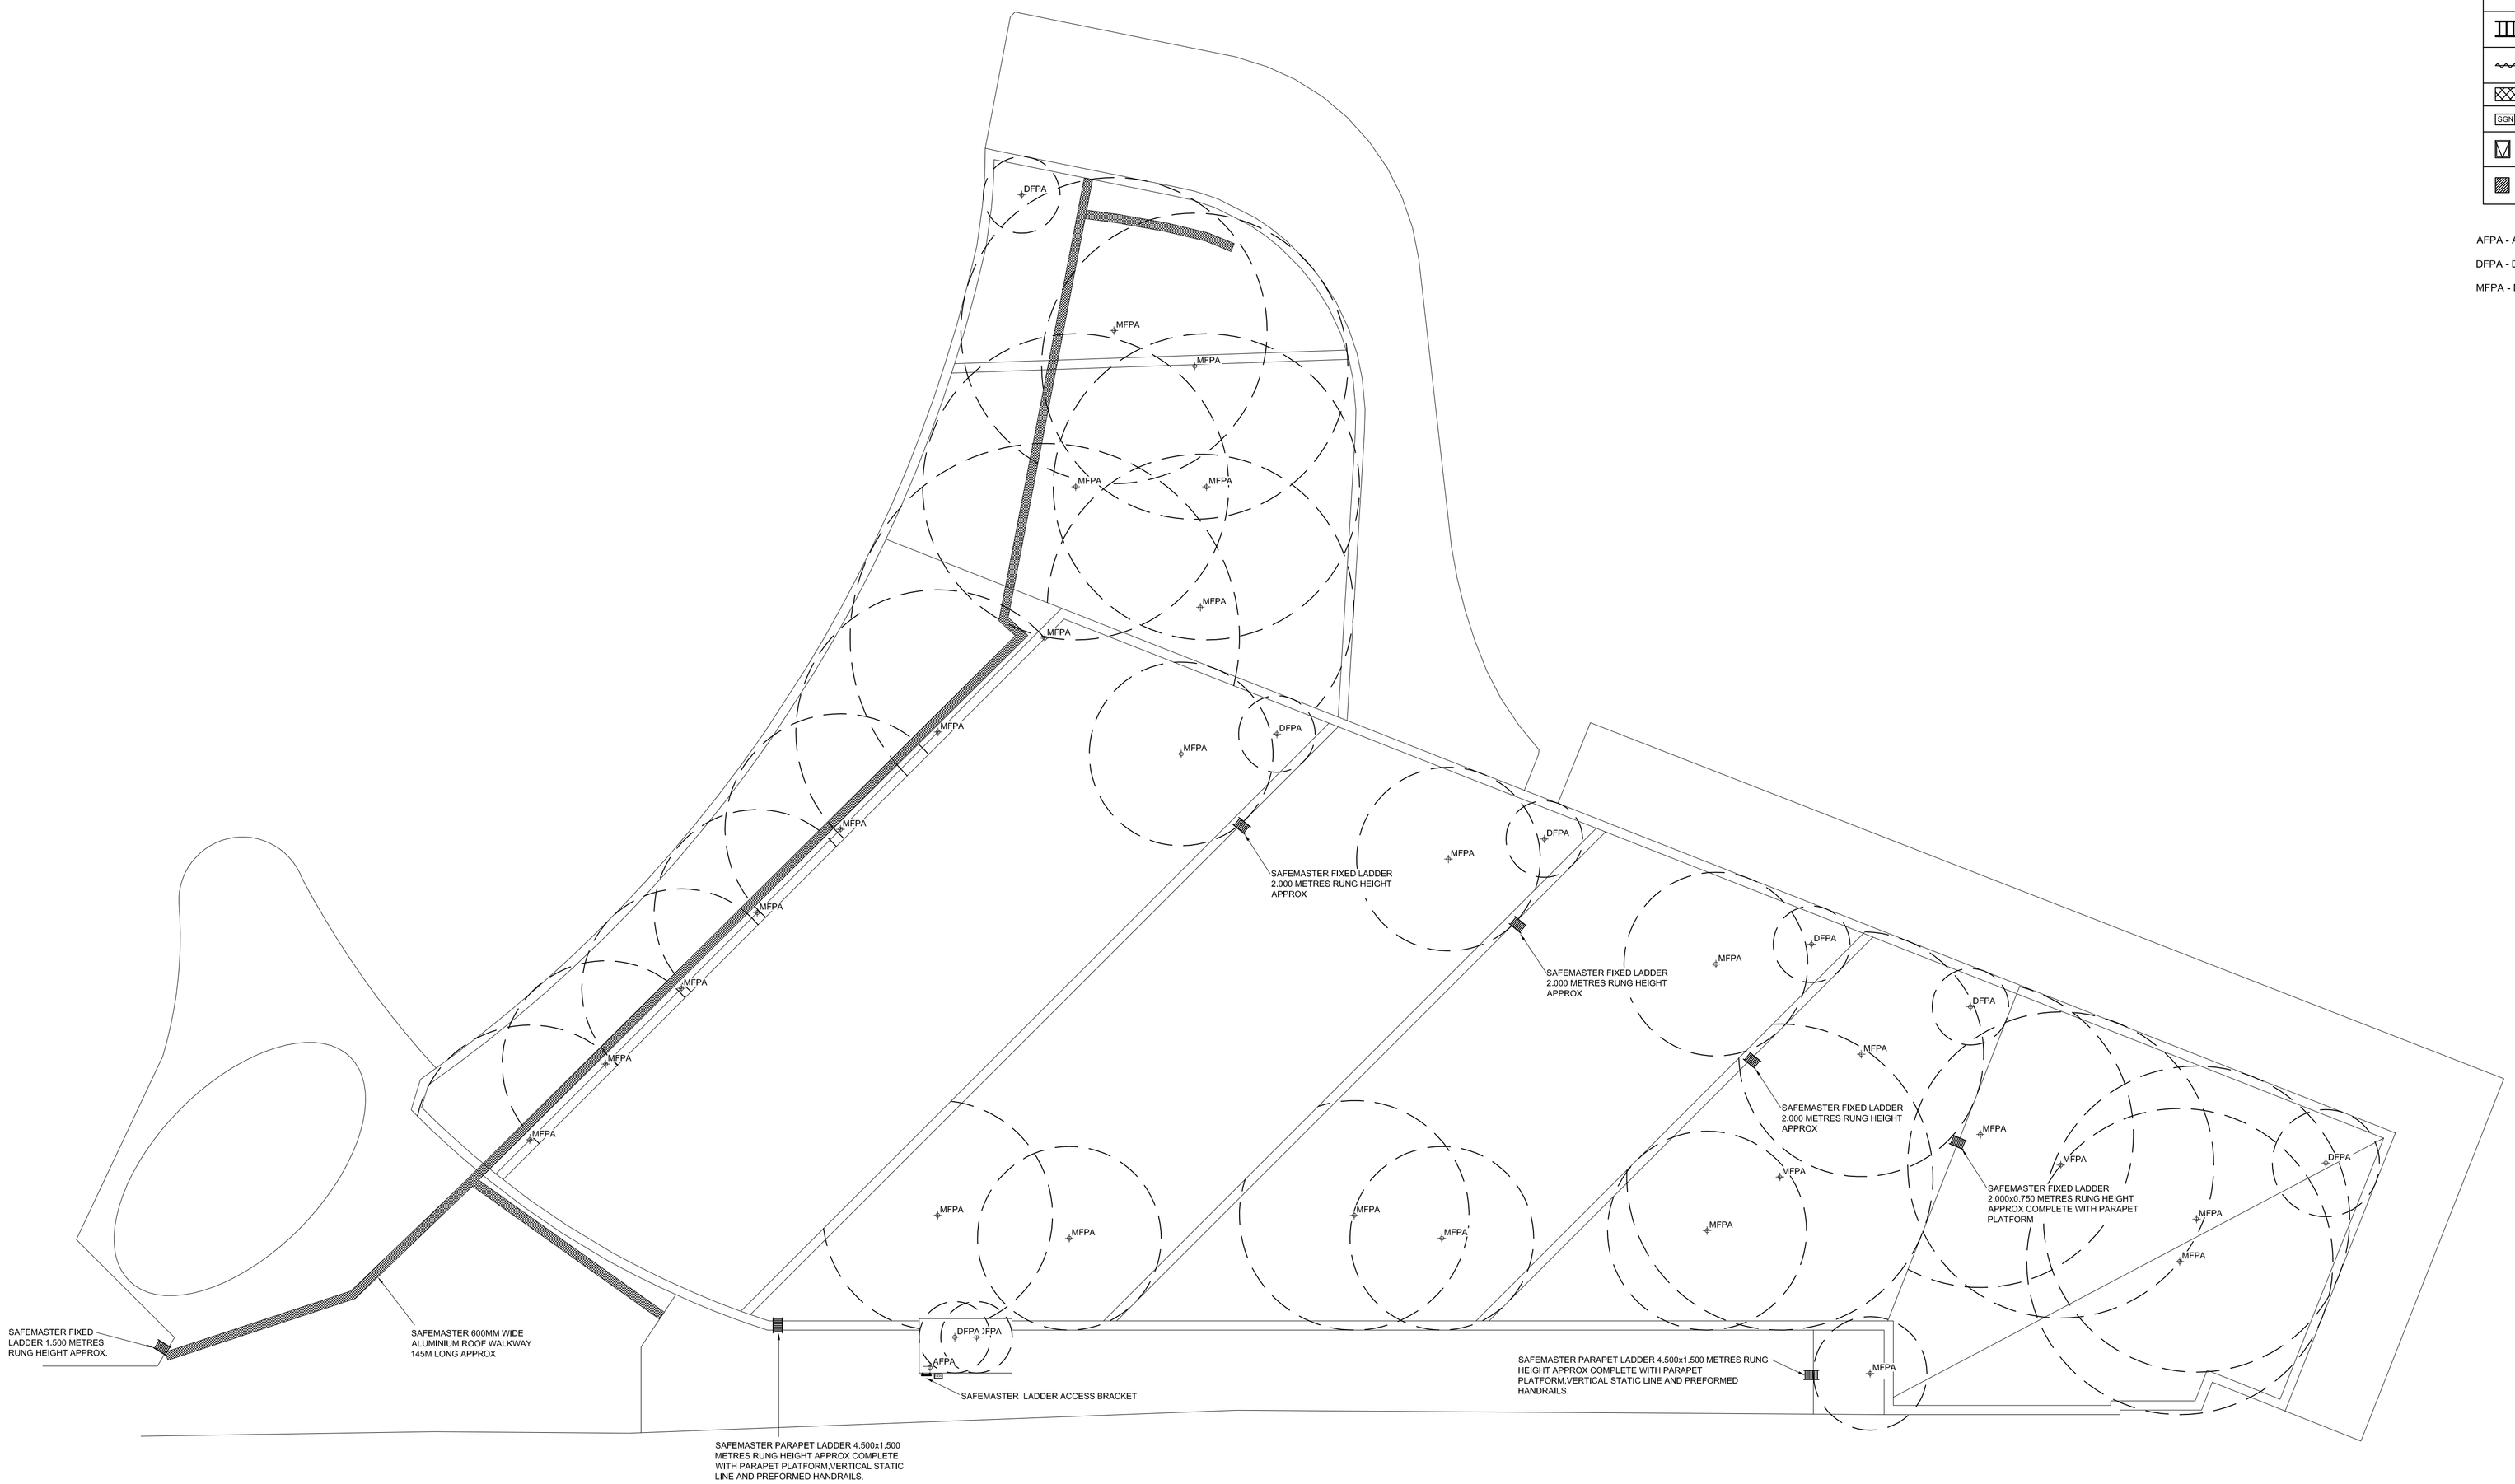

Designed GD	Date 11-10-12	Safemaster HEIGHT SAFETY SOLUTIONS Tel: (08) 6218 5158 Fax: (08) 9456 5014	BUSWOOD CASINO GAMING EXTENSION HEIGHT SAFETY DESIGN AS CONSTRUCTED
Drawn GD	Date 11-10-12		
Checked RMW	Date 11-10-12	THIS DRAWING AND THE COPYRIGHT THEREIN ARE THE PROPERTY OF SAFEMASTER SAFETY PRODUCTS AND IS NOT TO BE USED, REPRODUCED OR COPIED, WHOLLY OR IN PART WITHOUT THE WRITTEN PERMISSION OF SAFEMASTER SAFETY PRODUCTS.	A1

SCALE: 1:250 | DRAWING No: SM6484 | REV: -